


CROSSHATCH AREA INDICATES POD BATHROOM FOR APARTMENTS. POD TO BE CONSTRUCTED OFF SITE BY BUILDER COMPLETE WITH FIXTURES, TAPWARE, AND INTERNAL ABOVE SLAB DRAINAGE PIPEWORK. POD CONSTRUCTION SHALL INCLUDE RISERS EXTENDING TO BELOW AND CAPPED OFF BELOW SLAB FOR TOILET, HAND BASIN AND SHOWER. CONTRACTOR SHALL CONNECT TO RISERS AND EXTEND AS SHOWN IN ACCORDANCE WITH AS/NZS3500. REFER TO PART PLAN ON DRAWING NUMBER 'LCE13523-H17' FOR FURTHER INFORMATION (TYPICAL).

PROVIDE  $\phi 100$  CAPPED BRANCH OFF  $\phi 100$  TWV TO ALLOW FOR FUTURE CONNECTION AS PART OF CAFE FITOUT.

BULKHEAD REQUIRED TO ACCOMMODATE DRAINAGE FOR BATHROOM ABOVE.

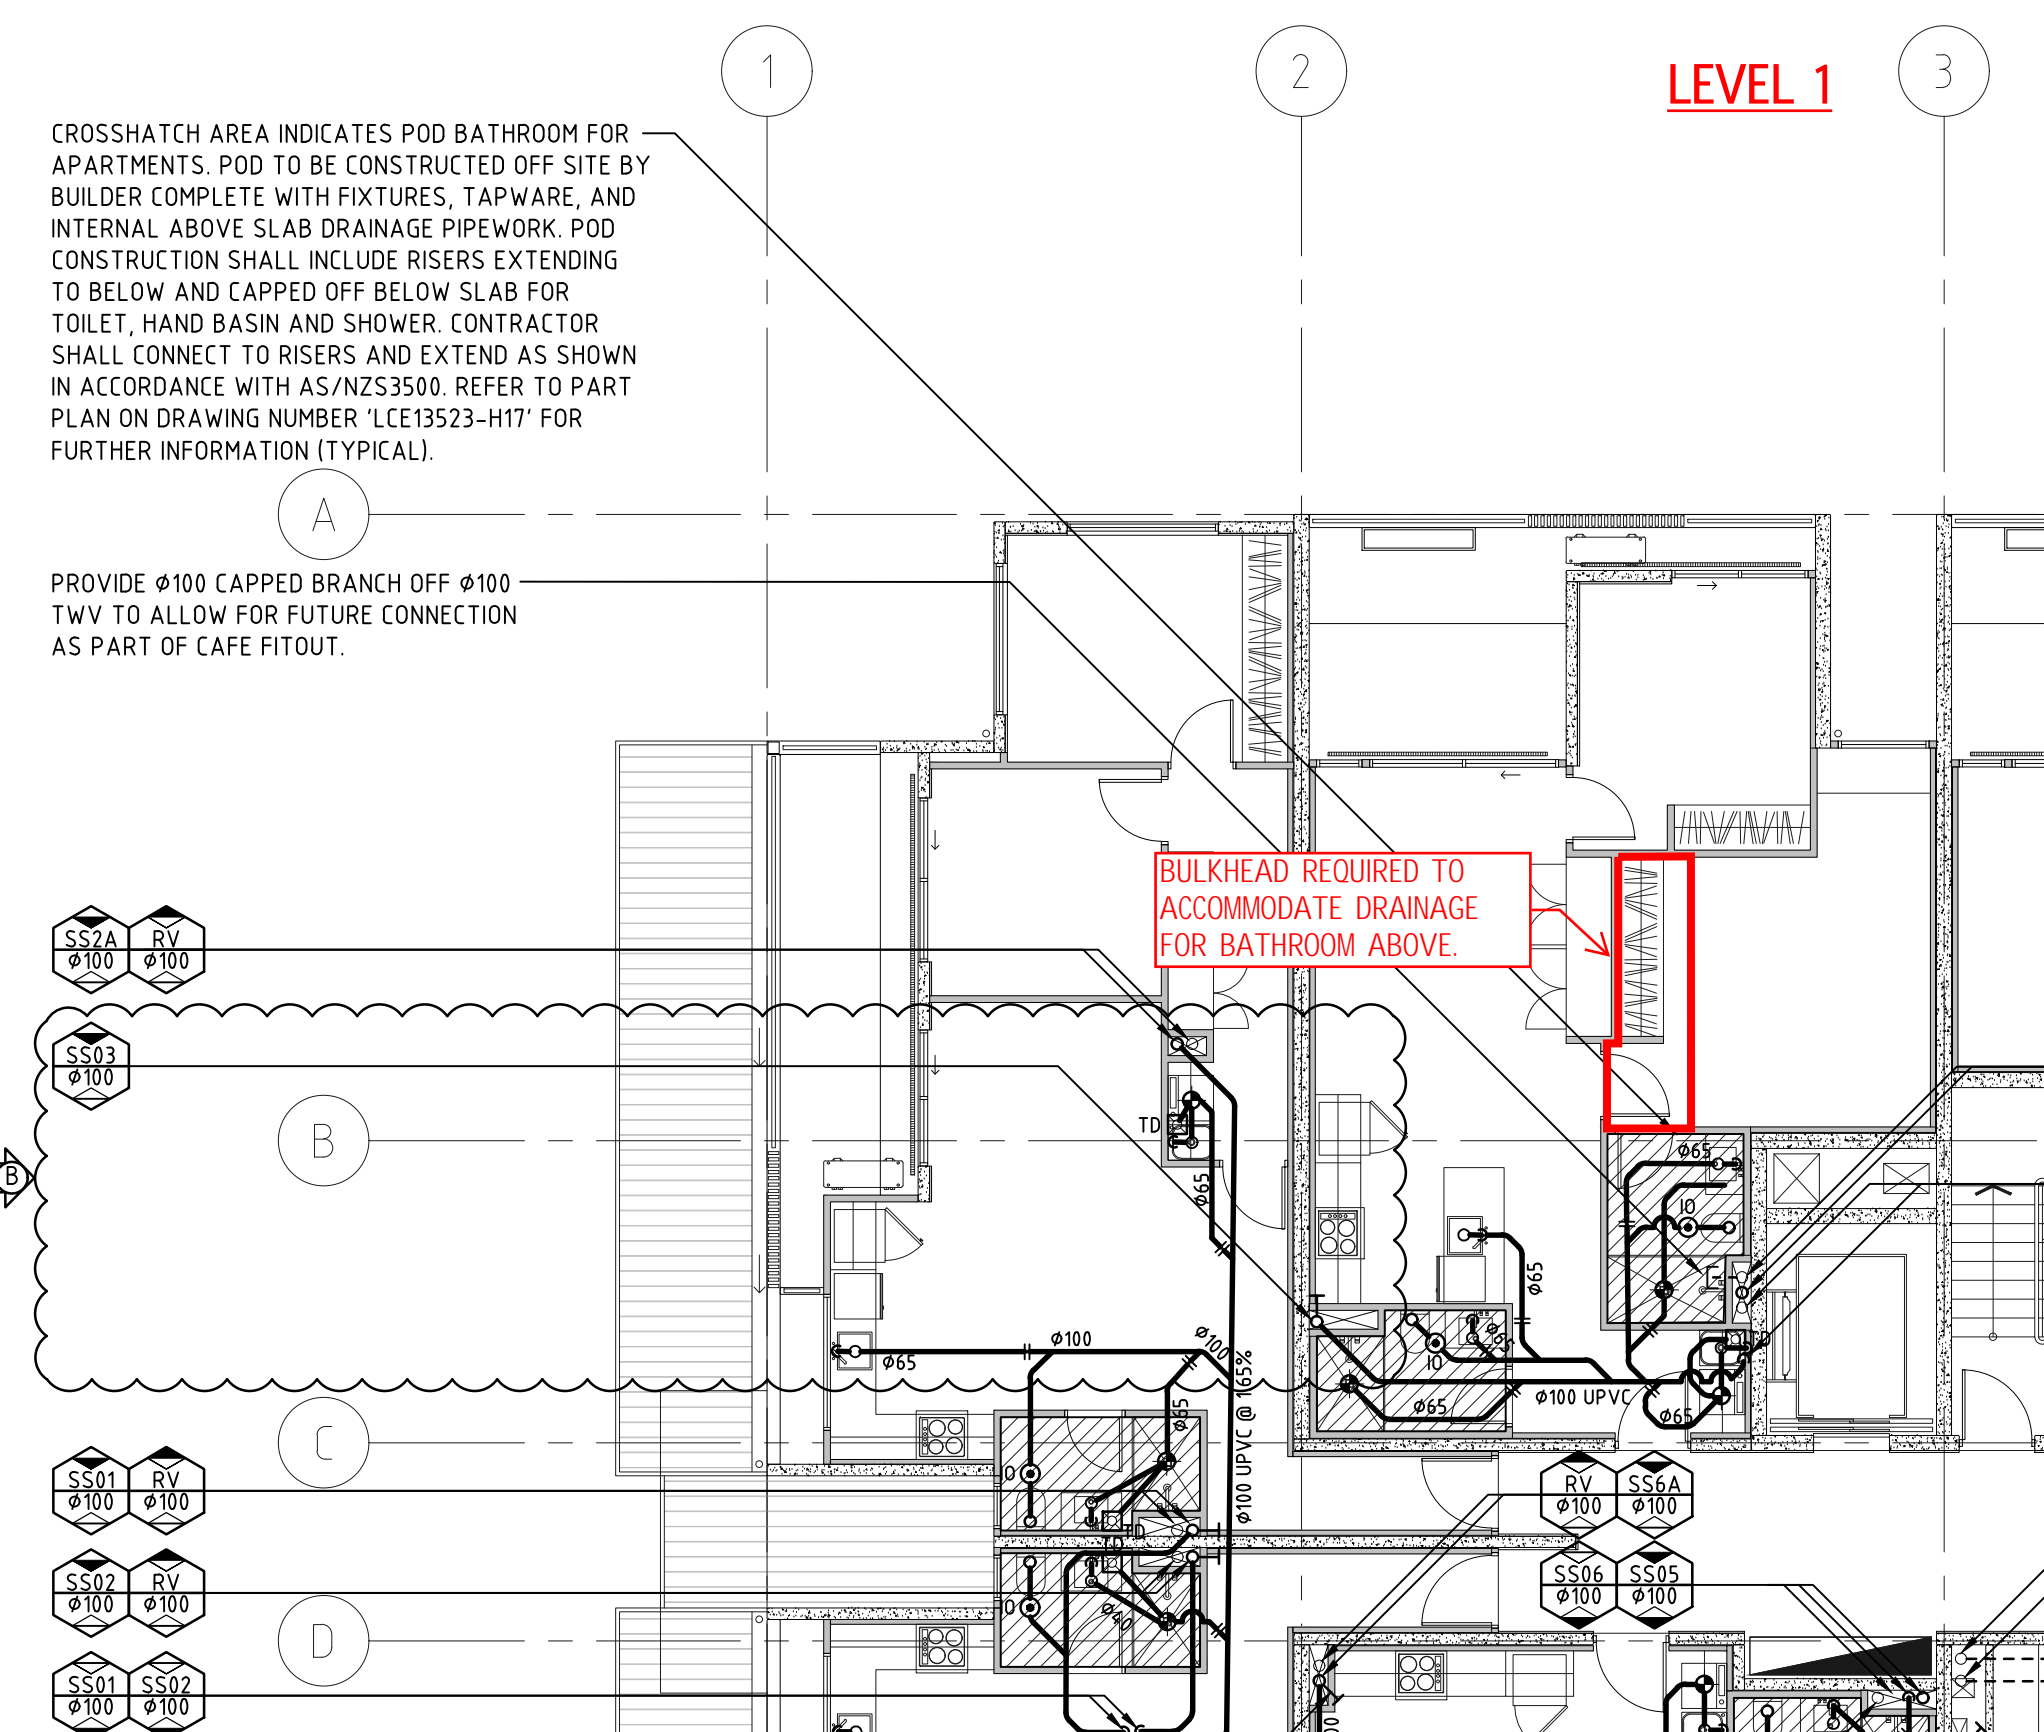

Ø50 BRANCH VENT SHALL EXTEND FROM SUSPENDED DRAINAGE, RISE UP IN WALL TO CEILING SPACE AND RETICULATE TO RELIEF VENT AS SHOWN. BRANCH VENT SHALL CONNECT TO RELIEF VENT IN ACCORDANCE WITH AS/NZS3500.

CROSSHATCH AREA INDICATES POD BATHROOM FOR APARTMENTS. POD TO BE CONSTRUCTED OFF SITE BY BUILDER COMPLETE WITH FIXTURES, TAPWARE, AND INTERNAL ABOVE SLAB DRAINAGE PIPEWORK. POD CONSTRUCTION SHALL INCLUDE RISERS EXTENDING TO BELOW AND CAPPED OFF BELOW SLAB FOR TOILET, HAND BASIN AND SHOWER. CONTRACTOR SHALL CONNECT TO RISERS AND EXTEND AS SHOWN IN ACCORDANCE WITH AS/NZS3500. REFER TO PART PLAN ON DRAWING NUMBER 'LCE13523-H17' FOR FURTHER INFORMATION (TYPICAL).

SS2A  
Ø100 RV  
Ø100 GV  
Ø50

SS03  
Ø100

SS03  
Ø100

BUILDER SHALL PROVIDE 200x200 BOXOUT IN CORNER OF KITCHEN TO CONCEAL Ø100 SEWER STACK.

GV  
Ø50 RV  
Ø100 SS01  
Ø100

GV  
Ø50 RV  
Ø100 SS02  
Ø100

LOWERED CEILING REQUIRED TO ACCOMMODATE DRAINAGE FOR BATHROOM ABOVE.

200mmx600mm MINIMUM CLEAR VOID FOR 100mm STACK

PROVIDE 80x40 PVC CONE TUNDRISH IN